

MARION COUNTY SURVEYOR'S OFFICE


SECTION CORNER RECORD

DEBRA S. JENKINS
MARION COUNTY SURVEYOR

SEC. 4 TWN. 15_N RNG. 2_E

BRYAN F. CATLIN, PLS
TECHNICAL SUPERVISOR

Date: 5-20-09
Party Chief: Greene
Crew: Taylor / Finney
Type of Marker: Harrison
Method of Establishment: County: 6-27-1994
IN S.P.C. E Zone, NAD 83
Name: 15020401
N: 503 147.977 8(m)
E: 43 436.551 8(m)

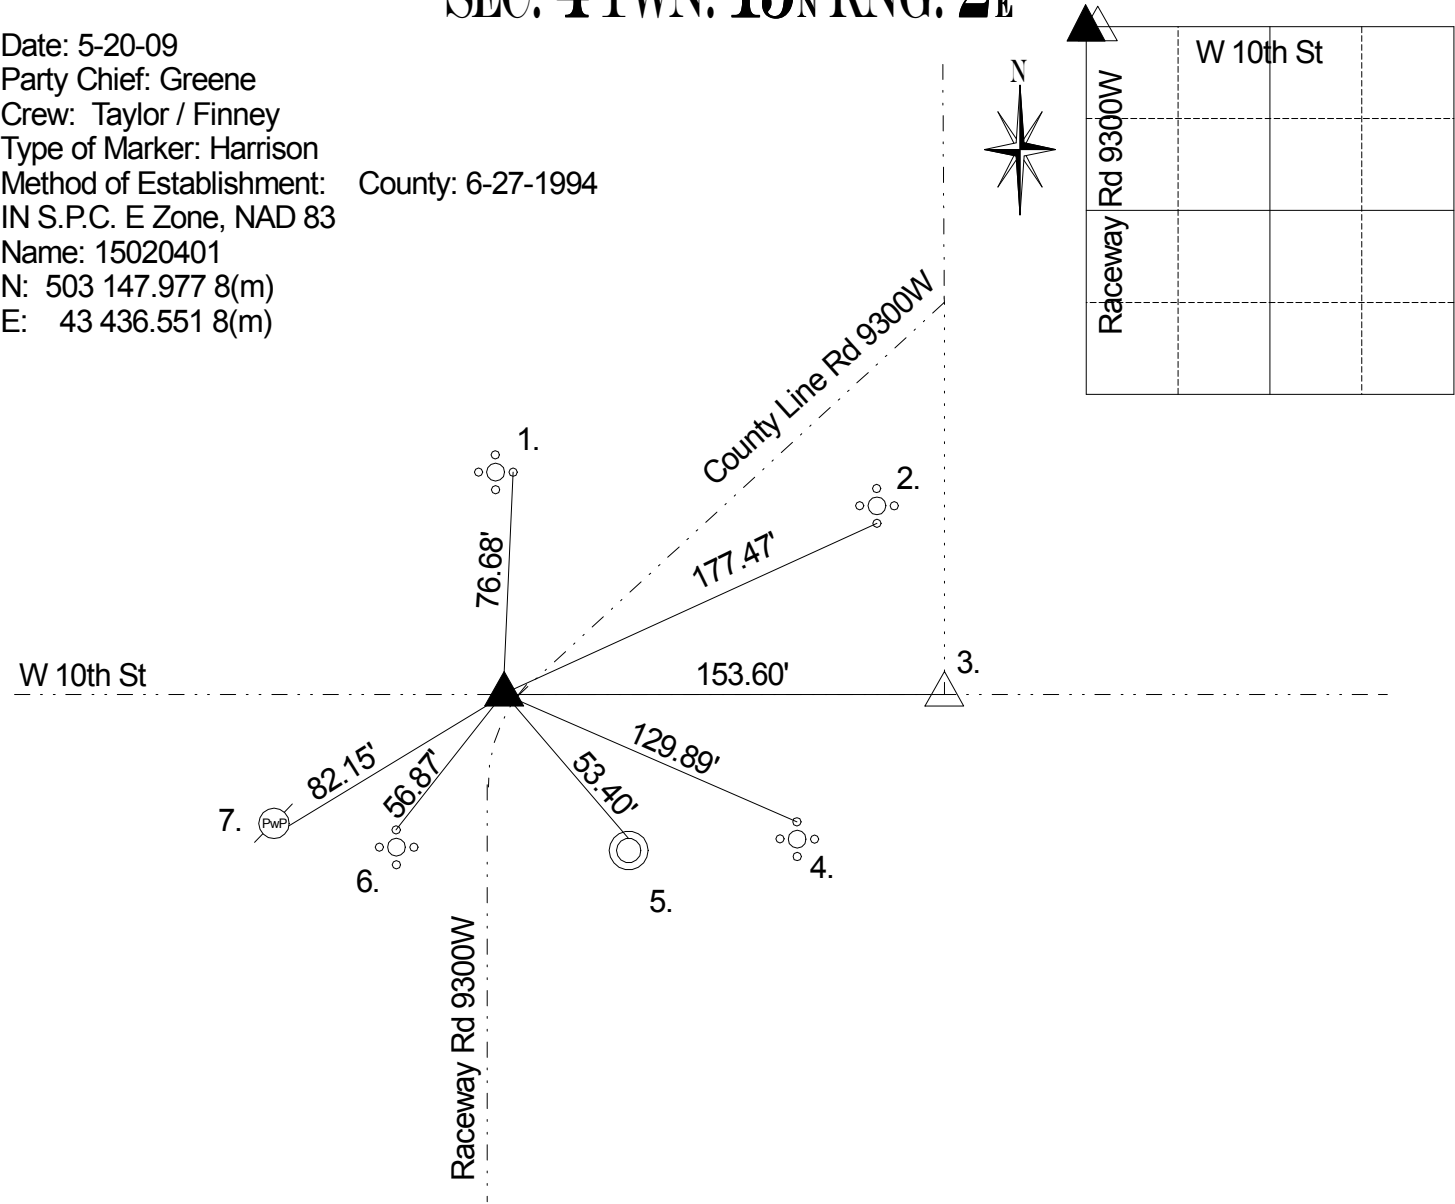

Original post set 1820 by Laughlin with witnesses: 10" beech S 67 E 11 links, 5" beech N 30 W 8 links per Marion County Atlas, pg. 2. Legal by Coyner 4-1900 found original rock set years ago... per Wayne Township Legal Survey Book pg. 88. Tie card 9-22-1947 called stone 10" down with 1 1/4" bolt over it. Thompson set this stone on line with stone 1/2 mile west. Tie card by Fox 4-10-57 called stone. Tie card by Monroe 3-58 called iron pin over stone. Tie card by Monroe 10-27-60 called steel pin over stone. Tie card by Straber 12-2-71 called iron pin over stone. McLand 3-7-75 called stone 10" down. Miller 3-23-76 called stone. Green 8-27-81 excavated and found PK nail at surface and RR spike 4" down, plugged pipe 6" down, stone 11" down. Wilcoxen 3-8-83 called stone. 6-16-94 Harrison set due to contruction. Retied by Wilcoxen 6-19-1999. Retied 7-11-2004 by Wilcoxen. Retied 5-20-09 by Greene.

REF.	DISTANCE	DESCRIPTION
1.	76.68'	Cut 'x' E bolt aluminum light pole
2.	177.47'	Cut 'x' S bolt aluminum light pole
3.	153.60'	Due E to Harrison SW corner 33-16-2 (16023307)
4.	129.89'	Cut 'x' N bolt aluminum light pole
5.	53.40'	Cut 'x' N rim traffic signal manhole
6.	56.87'	Cut 'x' N bolt aluminum light pole
7.	82.15'	PK nail E PwP # 20-491VA 24" up